\* DEPUTY ZONING COMMISSIONER

\* OF BALTIMORE COUNTY

\* Case No. 89-21-A John Joseph Rowan, Jr., et ux Petitioners

\* \* \* \* \* \* \* \* \* \* \*

## FINDINGS OF FACT AND CONCLUSIONS OF LAW

The Petitioners herein request a variance to permit a fence more than 3 feet high within a triangular area 10 feet from the point of intersection of the two street property lines in lieu of the required 25 feet, as more particularly described in Petitioner's Exhibit 1.

The Petitioners, by Mr. Rowan, appeared and testified. There were no Protestants.

Testimony indicated that the subject property, known as 9675 Dixon Avenue, is zoned D.R. 5.5 and is improved with an existing single family dwelling. Mr. Rowan testified that the fence in question was erected following receipt of permits in August 1986. As a result of a complaint filed by a resident of Dixon Avenue in March of 1988, the Petitioners became aware that the fence, which is 42 inches high, was constructed at a height greater than permitted pursuant to Section 102.5 of the Baltimore County Zoning Regulations (B.C.Z.R.) and thus, needed to be cut down or a variance obtained. Mr. Rowan indicated that after reviewing the situation and having the property review by Mr. Zuck of the Department of Traffic Engineering, the Petitioners opted to file the instant Petition for Zoning Variance. Mr. Rowan testified that Mr. Zuck met him at the

subject site on May 3, 1988 and after conducting various tests, determined that the height and location of the subject fence did not create a traffic hazard. In further support of Petitioners' request, Petitioners introduced as Petitioner's Exhibits 2A and 2B a petition signed by 16 residents of Dixon and Jomat Avenues who indicate that they are in support of the subject request.

Mr. Rowan testified that a denial of the requested variance would result in practical difficulty and unreasonable hardship to him as the fence has been on the property for almost 2 years without creating any problems or concerns, with the exception of this one complaint. Mr. Rowan indicated that he does not feel that the granting of the variance would result in any detriment to the health, safety or general welfare of the community as evidenced by the support of adjoining neighbors, the lack of any negative comments from the Department of Traffic Engineering, and no accidents having resulted at this location since the installation of the

Mrs. Antoinette Surock, the complainant in this matter, did not appear at the hearing, but submitted a letter dated July 17, 1988 which has been placed in the file.

The Petitioner's seek relief from Section 102.5 pursuant to Section 307 of the B.C.Z.R.

An area variance may be granted where strict application of the zoning regulations would cause practical difficulty to the Petitioner and his property. McLean v. Soley, 270 Md. 208 (1973). To prove practical difficulty for an area variance, the Petitioner must meet the following:

> 1) whether strict compliance with requirement would unreasonably prevent the use of the property for a permitted purpose or render conformance unnecessarily burdensome:

2) whether the grant would do substantial injustice to applicant as well as other property owners in the district or whether a lesser relaxation than that applied for would give substantial relief; and

3) whether relief can be granted in such fashion that the spirit of the ordinance will be observed and public safety and welfare secured.

Anderson v. Ed. of Appeals, Town of Chesapeake Beach, 22 Md. App. 28 (1974).

It is clear from the testimony that if the variance is granted, such use as proposed would not be contrary to the spirit of the B.C.Z.R. and would not result in substantial detriment to the public health, safety, and general welfare.

Pursuant to the advertisement, posting of the property, and public hearing on this Petition held, and for the reasons given above, the variance requested should be granted.

THEREFORE, IT IS ORDERED by the Deputy Zoning Commissioner for Baltimore County this Moday of July, 1988 that the Petition for Zoning Variance to permit a fence more than 3 feet high within a triangular area 10 feet from the point of interesection of the two street property lines in lieu of the required 25 feet, in accordance with Petitioner's Exhibit 1, be and is hereby GRANTED, subject, however, to the following restrictions:

> 1) The Petitioner is hereby made aware that proceeding at this time is at his own risk until such time as the applicable appellate process from this Order has expired. If, for whatever reason, this Order is reversed, the Petitioner would be required to return, and be responsible for returning, said property to its original condition.

2) The subject fence must be a minimum of 10 feet from the curb and on Petitioner's property and in no way located in any right-of-way.

> A M Nas farowia ANN M. NASTAROWICZ Deputy Zoning Commissioner for Baltimore County

AMN:bjs

PETITION FOR ZONING VARIANCE

TO THE ZONING COMMISSIONER OF BALTIMORE COUNTY: The undersigned, legal owner(s) of the property situate in Baltimore County and which is described in the description and plat attached hereto and made a part hereof, hereby petition for a Variance from Section 102.5 to permit a fence more than 3 ft high within. a triangular area 10 ft from the point of intersection of the two street property lines in lieu of the required 25 ft.

of the Zoning Regulations of Baltimore County, to the Zoning Law of Baltimore County; for the following reasons: (indicate hardship or practical difficulty) 1. Visual appearance would be improved to have a fence of uniform height, 42 in. 2.To keep the 42 in high fence 25 ft within the street property lines would cause the loss of a substantial portion of the yard, would invite pedestrian use of the lawn as a short cut(a distinct problem with resulting trash, animal feces, and lawn wear before the fence was constructed). 3. Fence location does not intefere with sight distance as the location, as determined by John Zuk, Traffic Inspector Baltimore County. (see back)
Property is to be posted and advertised as prescribed by Zoning Regulations.

I, or we, agree to pay expenses of above Variance advertising, posting, etc., upon filing of this petition, and further agree to and are to be bound by the zoning regulations and restrictions of Baltimore County adopted pursuant to the Zoning Law For Baltimore County,

under the penalties of perjury, that I/we are the legal owner(s) of the property which is the subject of this Petition. MAPNE 10E Contract Purchaser: Legal Owner(s): John Joseph Rowan, Jr. (Type or Print Name) (Type or Print Name) The Row of DATE 12-9-Signature MARY JILL ROWAN Address (Type or Print Name) mary Viel Howar Attorney for Petitioner: 9675 DIXON AUE Type or Print Name) Balto MD 21234-2101 City and State Name, address and phone number of legal owner, contract purchaser or representative to be contacted Mary Jill Rowan Name 9675 Dixon Ave. City and State Balto, MD 21234 665-9578 Attorney's Telephone No.: ORDERED By The Zoning Commissioner of Baltimore County, this

Zoning Commissioner of Baltimore County

PROPERTY DESCRIPTION

Located on the southeast corner of Dixon Avenue and Jomat Avenue and known 25 Lct 29, Block "A", as shown on the "Third Amended Plat of Robin Ridge" and recorded among the Land Records of Baltimore County in Plat Book EHK, Ir 52, Folio 25.

From as 9675 Dixon Avenue in the 9th Election District

CERTIFICATE OF PUBLICATION

The Zaming Commissioner of Bal-timore County, by authority of the Zoning Act and Regulations of Balti-more County will hold a public hearing on the property identified THIS IS TO CERTIFY, that the annexed advertisement was bereit in Room 106 of the County Office Building, Incated at 111 W. Chesapeake Avenue in Tourson, Maryland as follows: published in the TOWSON TIMES, a weekly newspaper printed Petition for Zoning Variance Case number: 89-21-A SEC Dison Avenue and Jonal and published in Towson, Baltimore County, Md., once in each 9675 Discon Avenue) 9th Election District successive weeks, the first publication appear-6th Councilmanic District Petitioner(s): John Joseph Rowan, Jr., et ax Hearing Date: Wednesday, June 20, 2908 at 11:00 a.m. ariance: to permit a fence mon than 3 ft. bigh water a transpular area of 10 ft. from the point of in-

\$ 58.00

NOTICE OF HEARING

The Zorang Commissioner of Bal-timore County, by authority of the Zorang Act and Regulations of Balti-more County will hold a public hearing on the property identified herein in Room 106 of the County Office Building, located at 111 W. Chesapeake Avenue in Towson, Maryland as follows:

Petition for Zoning Variance
Case Number: 89-21-A
SE/C Dison Avenue and Jomat
Avenue (9675 Dison Avenue)
9th Election District
6th Councilmanic District
Petitioner(s):
John Joseph Rowan, Jr., et us.
Hearing Date: Wednesday,
July 20, 1988 at 11:00 a.m.
Variance to permit a feron more

Variance to permit a sence more than 3 ft. high within a triangular area of 10 ft. from the point of in-

tersection of the two street property lines in lieu of the required 25 ft. In the event that this Petition is

grant. d. a busiding permit may be issued a 'Can the thirty (30) day an

issued a 'thin the thirty (30) day appeal period. The Zoring Commissioner will, however, entertain any request for a stay of the issuance of said permit during this period for good cause shown. Such request must be in writing and received in this office by the date of the hearing set above or preserted at the hearing.

J. ROBERT HAINES
Zoning Commissioner of
Baltimore County

NOTICE OF PEARING

terrection of the two street propert lines in lieu of the required 25 ft.

In the event that this Petition i

granted, a building permit may be issued within the theiry (30) day ap-

peal period. The Zoning Commis-siance will, however, entertain any

request for a stay of the insuance of said permit during this period for good cause shown. Such request must be in writing and received in

this office by the date of the hearing set above or presented at the hear-

-270 June 22.

CERTIFICATE OF PUBLICATION

TOWSON, MD., Que 23, 1988

THIS IS TO CERTIFY, that the annexed advertisement was published in THE JEFFERSONIAN, a weekly newspaper printed and published in Towson, Baltimore County, Md., once in each successive weeks, the first publication appear-

THE JEFFERSONIAN,

5. Zete Orlina

33.75

I/We do solemnly declare and affirm, of \_\_\_\_\_\_\_, 1950, that the subject matter of this petition be advertised, as required by the Zoning Law of Baltimore County, in two newspapers of general circulation throughout Baltimore County, that property be posted, and that the public hearing be had before the Zoning

CERTIFICATE OF POSTING ZONING DEPARTMENT OF BALTIMORE COUNTY

Toursen, Maryland		
sor: Varianco	Date of Posting 6/79/87	
John Joseph Rowon In	- Jup	
go of property: SELEUX PIXON RYS &		
a of Signer Facing DIXON ANY OF	15' Fx. 400 dway	
Oxerouty of fot. Tioner		ارا
by Milestys Signature	Date of return: 4/31/88	

Dennis F. Rasmussen

Enclosed please find the decision rendered on the above-refer-

Very truly yours,

ANN M. NASTAROWICZ

for Baltimore County

Deputy Zoning Commissioner

In the event the decision rendered is unfavorable to any party, please be advised that any party may file an appeal within thirty (30) days of the date of the Order to the County Board of Appeals. If you require additional information concerning filing an appeal, please feel free to contact our Appeals Clerk at 494-3391.

July 27, 1988

AMN:bjs Enclosure

cc: Ms. Anto\_nette Surock 9671 Dixon Avenue, Baltimore, Md. 21234

File

SE/Corner Dixon Avenue and Jomat Avenue 9th Election District; 6th Councilmanic District Case No. 89-21-A

Dear Mr. & Mrs. Rowan:

enced case. The Petition for Zoning Variance has been granted in accordance with the attached Order.

People's Counsel

9675 Dixon Avenue

Mr. & Mrs. John J. Rowan, Jr. Baltimore, Maryland 21234-2101 RE: PETITION FOR ZONING VARIANCE

Office of Planning & Zoning Towson, Maryland 21204 494-3353

J. Robert Haines Zoning Commissione

**Baltimore County** 

Zoning Commissioner

## BALTIMORE COUNTY OFFICE OF PLANNING & ZONING

County Office Building 111 W. Chesapeake Avenue Towson, Maryland 21204

Your petition has been received and accepted for filing this \_\_\_\_\_\_ day of \_\_\_\_\_\_, 1988.

Petitioner John J. Rokan, Jr., et ux Received by: Petitioner's Advisory Committee Attorney

No. <u>5</u>2459 BALTIMORE COUNTY, MARYLAND OFFICE OF FINE - REVENUE DIVISION MISCELLANEOUS CASH RECEIPT VALIDATION OR SIGNATURE OF CASHIER

> BALTIMORE COUNTY, MARYLAND
> OFFICE OF FINE E-REVENUE DIVISION
> MISCELLANEOUS CASH RECEIPT DATE 3/20/82 01-615-000 FOR Destine & Advartising (89-21-A)

> > VALIDATION OR SIGNATURE OF CASHIER

B 8008\*\*\*\*\*10875:a 02648

Baltimore County Zoning Commissioner Office of Planning & Zoning Towson, Maryland 21204

J. Robert Haines Zoning Commissioner

Date: 6-39-88

Mr. & Mrs. John Joseph Rowan, Jr. 9875 Dixon Avenue Baltimore, Maryland 21234

Res Putition for Zoning Variance CASE NUMBER 89-21-A SE/C Dixon Avenue and Jomat Avenue (9875 Dixon Avenue) 9th Election District - 5th Councilmanic Petitioner(s): John Joseph Rowen, Jr., et ux HEARING SCHEDULED: WEDNESDAY, JULY 20, 1888 at 11:00

Dear Mr. & Mrs. Rowans

Please be advised that  $\frac{106.75}{100.75}$  is due for advertising and posting of the above-referenced property. All fees must be paid prior to the hearing. Do not remove the sign and post set(s) from the property from the time it is posted by this office until the day of the hearing itself.

THIS FEE MUST BE PAID AND THE ZONING SIGN(S) AND POST(S) RETURNED ON THE DAY OF THE HEARING OR THE ORDER SHALL NOT BE ISSUED.

Please make your check payable to Baltimore County, Maryland and bring it along with the sign(s) and post(s) to the Zoning Office, County Office Building, Room 111, Towson, Maryland 21204 fifteen (15) minutes before your hearing is scheduled to begin.

Please note that should you fail to return the sign and post set(s), there will be an additional \$25.00 added to the above fee for each set not returned.

Very truly yours,

Robert Haines J. ROBERT HAINES Zoning Commissioner of Baltimore County

cc: File

Zoning Commissioner Office of Planning & Zoning Towson, Maryland 21204 494-3353 J. Robert Haines Zoning Commissioner

June 3, 1988

## NOTICE OF HEARING



The Zoning Commissioner of Baltimore County, by authority of the Zoning Act and Regulations of Baltimore County will hold a public hearing on the property identified herein in Room 106 of the County Office Building, located at 111 W. Chesapeake Avenue in Towson, Maryland as follows:

Petition for Zoning Variance CASE NUMBER: 89-21-A SE/C Dixon Avenue and Jomet Avenue (9675 Dixon Avenue) Sth Election District - 6th Councilmenic Petitioner(s): John Joseph Rowen, Jr., et ux HEARING SCHEDULED: MEDNESDAY, JULY 20, 1988 at 11:00 a.m.

VARIANCE to permit a fence more than 3 ft. high within a triangular area of 10 ft. from the point of intersection of the two street proproperty lines in lieu of the re-

In the event that this Petition is granted, a building permit may be issued within the thirty (30) day appeal period. The Zoning Commissioner will, however, entertain any request for a stay of the issuance of said permit during this period for good cause shown. Such request must be in writing and received in this office by the date of the hearing set above or presented at the hearing.

HELTIMORE COUNTY, MARLAND

INTER-OFFICE CORRESPONDENCE

There are no comprehensive planning factors requiring

Office of Planning and Coning

SUBJECT Zoning Petitions #89-4-A, 89-5-A, 89-14-A, 89-15-A, 89-16-A, 89-17-A, 89-19-A, 89-21-A, 89-23-A, 89-25-A, 89-27-A, 89-28-A, 89-29-A, and 89-34-A

J. ROBERT HAINES Zoning Commissioner of Baltimore County

John Joseph Rowen, Jr., et ux Mcs. Toni Surock

Zoning Commissioner

P. David Fields, Director
Office of Planning and Zoning

comment on these petitions.

J. G. Hoswell

Zoning File

cc: Shirley Hess, People's Counsel

BALTIMORE COUNTY ZONING PLANS ADVISORY COMMITTEE

MEMBERS

Bureau of

Bureau of

Industrial

Engineering

Department of

COUNTY OFFICE BLDG. 111 W. Chesapeake Ave. Towson, Maryland 21204 Mr. & Mrs. John J. Rowan, Jr., et ux 9675 Dixon Avenue Baltimore, Maryland 21234-2101

> RE: Item No. 404 - Case No. 89-21-A Petitioner: John J. Rowan, Jr., et ux Petition for Zoning Variance

July 11, 1988

Dear Mr. & Mrs. Rowan:

Traffic Engineering State Roads Commissio The Zoning Plans Advisory Committee has reviewed the plans submitted with the above referenced petition. The following comments are not intended to indicate the appropriateness of the Fire Prevention zoning action requested, but to assure that all parties are made Health Department Project Planning Building Department Board of Education Zoning Admiristration

aware of plans or problems with regard to the development plans that may have a bearing on this case. Director of Planning may file a written report with the Zoning Commissioner with recommendations as to the suitability of the requested zoning. Enclosed are all comments submitted from the members of the Committee at this time that offer or request information on your retition. If similar comments from the remaining members are

received, I will forward them to you. Otherwise, any comment that is not informative will be placed in the hearing file. This petition was accepted for filing on the date of the enclosed filing certificate and a hearing scheduled accordingly.

Very truly yours,

JAMES E. DYER Zoning Plans Advisory Committee

ZED:dt Enclosures

Baltimore County De; attment of Public Works Bureau of Traffic Engineering Courts Building, Suite 405 Towson, Maryland 21204 494-3554

June 23, 1988



Mr. J. Robert Haines Zoning Commissioner County Office Building Towson, Maryland 21204

Dear Mr. Haines:

The Bureau of Traffic Engineering has no comments for items number 399, 400, 402 404, 405, 406 and 407.

> Very truly yours. Stephen E. Weber, P.E. Assistant Traffic Engineer

SEW/RF/pm1-5

Baltimore County Fire Department Towson, Maryland 21204-2586 Paul H. Reincke Chief

May 13, 1988

J. Robert Haines Zoning Commissioner Office of Planning and Zoning Baltimore County Office Building Towson, MD 21204

Re: Property Owner: John Joseph Rowan, Jr., et ux

Location: SE/C Dixon Avenue, & Jomat Avenue Item No.: 404

Zoning Agenda: Meeting of 5/17/88

Pursuant to your request, the referenced property has been surveyed by this Bureau and the comments below marked with an "X" are applicable and required to be corrected or incorporated into the final plans for the property.

( ) 1. Fire hydrants for the referenced property are required and shall be located at intervals or \_\_\_\_ feet along an approved road in accordance with Baltimore County Standards as published by the Department of Public Works.

( ) 2. A second means of vehicle access is required for the site.

( ) 3. The vehicle dead end condition shown at \_

( ) 4. The site shall be made to comply with all applicable parts of the Fire Prevention Code prior to company or beginning of operation.

EXCEEDS the maximum allowed by the Fire Department.

( ) 5. The buildings and structures existing or proposed on the site shall comply with all applicable requirements of the National Fire Pro-tection Association Standard No. 101 "Life Safety Code," 1976 edition


( ) 6. Site plans are approved, as drawn.

(x) 7. The Fire Prevention Bureau has no comments at this t

Planning Group
Special Inspection Division

Fire Prevention Bureau

cc: Mr. & Mrs. John Joseph Rowan, Jr.

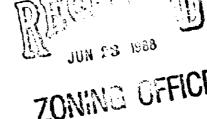

BALTMORE COUNTY, MARYLAND

INTER-OFFICE CORRESPONDENCE

James Dier Zoning Supervisor

James Thompson FROM Zoning Enforcement Coordinator Item No.: 404 (if known)
SUBJECT Fetitioner: ROWAN (if known)

VIOLATION CASE \* (-83-167)

LOCATION OF VICIATION 9675 DIXON AVENUE & JOMAT AVE DEFENDANT 10 - L & MARY ROWAN ADDRESS BALTIMURE, NO 21234

Flease te advised that the aforementioned petition is the subject of an active violation case. When the petition is scheduled for a public hearing, please notify the following persons:

MARS TONI SERCET

9671 DIXON AUE. BALTIMORE, M.D. 21234

After the public hearing is held, please send a copy of the Zoning Commissioner's Order to the Zoning Enforcement Coordinator, so that the appropriate action may be taken relative to the violation case.

/jl

BELLUSE OF HUS FINDINGS WE CAN
FINALLY CLOSE OUT LASE NO. C-88-1671, 9675 DIXON AVE.

JOHN 🤼 ROWAN, JR. JILL WAN 9675 DIXON AVENUE BALTIMORE, MARYLAND 21234

JULY 15, 1988

(301)665-9578

Dear Resident:

In August of 1986, we had installed, a 42"H cedar picket fence on the south side of our property adjacent to Jomat Avenue(see attached drawing). The fence was constructed by an established and reputable fencing contractor and we believed that it complied with all applicable Baltimore County building and zoning codes. In all applicable Baltimore County building and zoning codes. In March of this year(1988) a resident filed a complaint with the Baltimore County zoning office indicating that the fence interfered with visibility. A Baltimore County zoning inspector subsequently viewed the area and indicated that we needed to reduce the height of the fence by 6" for 25 feet in each direction from the intersection or file for a zoning variance. At our request, the traffic engineer for Baltimore County examined the intersection on May 3rd and concluded that the existing force did intersection on May 3rd and concluded that the existing fence did not conflict with guidelines for traffic safety. We subsequently filed for a zoning variance and a public hearing will be held in ROOM #106 of the COUNTY OFFICE BUILDING on July 20th at 11:00

If you will not be attending this hearing but you SUPPORT a zoning variance to allow the fence to remain at its existing height, please sign below:

9668 Dron DUE -665-9340 9668 DUDY JUE 9664 DIXON Ave 961.2 DIXON fOE 882-2430 9660 DIKON FRE 665-5372 9554 Dixa A 455-472 9656 DIXON Rd 882-4076

PETTONE

July 17, 1988

Baltimore County Zoning Commissioner Office of Planning and Zoning Towson, MD 21204

ATTENTION: J. Robert Haines Zoning Commissioner

RE: PETITION FOR ZONING VARIANCE CASE NUMBER: 89-21A Hearing Date: Wednesday, July 20, 1988

Dear Zoning Commissioner:

To support my complaint, on the above mentioned Case No. 89-21A, I have the following comments:

The zoning violation for this property was brought to my attention in mid 1987 when I requested a stop sign at the intersection in question. My request was made, by phone, to Mr. Zuk who is in the Baltimore County Office of Traffic signs. He checked the intersection very closely and did the following; placed a stop sign on the S/E Corner of Dixon and Jomat Avenues (property with zoning violation) and posted No Parking signs on the opposite corner (which is a small parcel of land owned by Baltimore County). When he called me with the results of his actions he indicated that he felt the intersection would benefit from the stop sign and no parking signs. He did, however, mention that the fence on that S/E corner may obstruct sight distance and may also be a zoning violation. We left it at that and had no more communication, at that time. I have spoken with him recently, in regards to this complaint, and his feeling now is that the drivers stopping at the stop sign don't really have to stop at the sign but can proceed as far as ten feet into the intersection to see if it is safe to proceed. I don't think this is what is supposed to happen at intersections with stop

In the following months my family and I have had, on too many occasions, near misses on this corner because the fence has obstructed our view as well as the other driver involved. The driver stopping at the stop sign cannot see beyond the fence and must proceed into the intersection very slowly in order to see if a car is approaching. This same driver can see if it is a truck or a van but not a passenger car because of the height of the fence. In fact, newer cars are getting smaller not larger. Drivers approaching the intersection from the opposite way (other side of the fence) cannot see if a car is stopped or coming through the intersection. This is the reason for my complaint. I am concerned that this fence is a safety hazard.

To further support my complaint, I have enclosed a copy of the Declaration of Convenants, Conditions, Restrictions and Easements covering The Robin Ridge Community. All property owners in our new development (1958 to 1975 Dixon Avenue) signed, at settlement, that they accepted

> JOHN JOHN JR. JILL BAN 9675 DIXON AVENUE BALTIMORE, MARYLAND 21234 (301)665-9578

JULY 15, 1988

Dear Resident:

In August of 1986, we had installed, a 42"H cedar picket fence on the south side of our property adjacent to Jomat Avenue(see attached drawing). The fence was constructed by an established and reputable fencing contractor and we believed that it complied with all applicable Baltimore County building and zoning codes. In March of this year(1988) a resident filed a complaint with the Baltimore County zoning office indicating that the fence interfered with visibility. A Baltimore County zoning inspector subsequently viewed the area and indicated that we needed to reduce the height of the fence by 6" for 25 feet in each direction from the intersection or file for a zoning variance. At our request, the traffic engineer for Baltimore County examined the intersection on May 3rd and concluded that the existing fence did not conflict with guidelines for traffic safety. We subsequently filed for a zoning variance and a public hearing will be held in ROOM #106 of the COUNTY OFFICE BUILDING on July 20th at 11:00 A.M..

If you will not be attending this hearing but you SUPPORT a zoning variance to allow the fence to remain at its existing height, please sign below:

1804 forat Tue 21234 661-8213 9630 Dixon Are 21234 882-5805 9658 DIXON AVE ZIZZH 668.0439 9646 Dixon Ove 21234 665-3043 9643 DIXIN Noc. 21274 661.5077 Marie Riccione 9645 Difor Art. 21234 665-0587 Thomas M. Morris 2803 JOMATAVEZI234 6619059

118586 6 2 4 4. 0 1 3

DECLARATION OF COVENANTS, CONDITIONS, RESTRICTIONS AND EASEMENTS COVERING ROBIN RIDGE

THIS DECLARATION is made this ... day of October, 1983, by and among Thanner Development Corporation (referred to hereinafter as the "Developer") party of the first part; and Municipal Savings & Loan Association, Inc. (hereinafter "Municipal") and Marie E. Ciekot (hereinafter "Ciekot") collectively, parties of the second part; Fork Construction Co. (hereinafter the "Builder"), party of the third part; and Reisterstown Federal Savings & Loan Association (hereinafter "Reisterstown"), party of the fourth part.


WHERZAS, the Developer is the owner, in fee simple, of all those lots of ground shown on the Plat entitled "Amended Plat of Robin Ridge", (the "Plat") which Plat is recorded among the Plat Records of Ealtimore County at Plat Book E.H.K., Jr., 46, folio 150 (the "Subject Land"); and WHEREAS, the Developer, for the purpose of creating and maintaining a general scheme of development, desirect what EHK JR T 69.00 the Subject to the covenants #78978 COUZ ROZ TILE 23 restrictions hereinafter set forth; and


WHEREAS, Municipal, as holder of a first mortgage on the Subject Land, dated June 30, 1983 and recorded among the Land Records of Baltimore County in Liber E.H.K., Jr. 6550, folio 341, joins herein to signify its assent to the imposition of the restrictions set forth herein and to subordinate its mortgage hereto;

WHEREAS, Ciekot, as holder of a second mortgage on the Subject Land, dated June 30, 1983 and recorded among the Land Records of Baltimore County in Liber E.H.K., Jr. 6550,. folio 346, joins herein to signify her assent to the subordinate her mortgage hereto; imposition of the restrictions set forth herein and to

TRANSFER TAX FICT REQUIRED Director of Finance

DR 65/ZONE

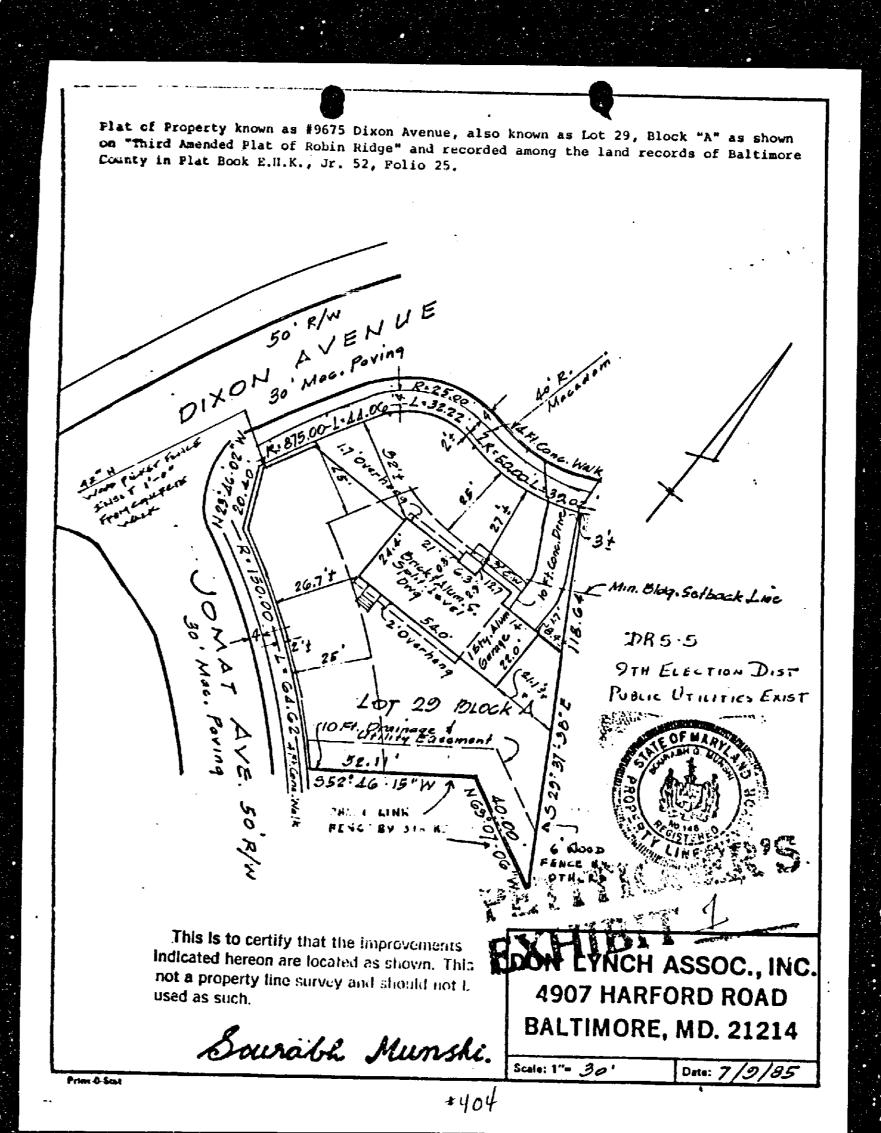

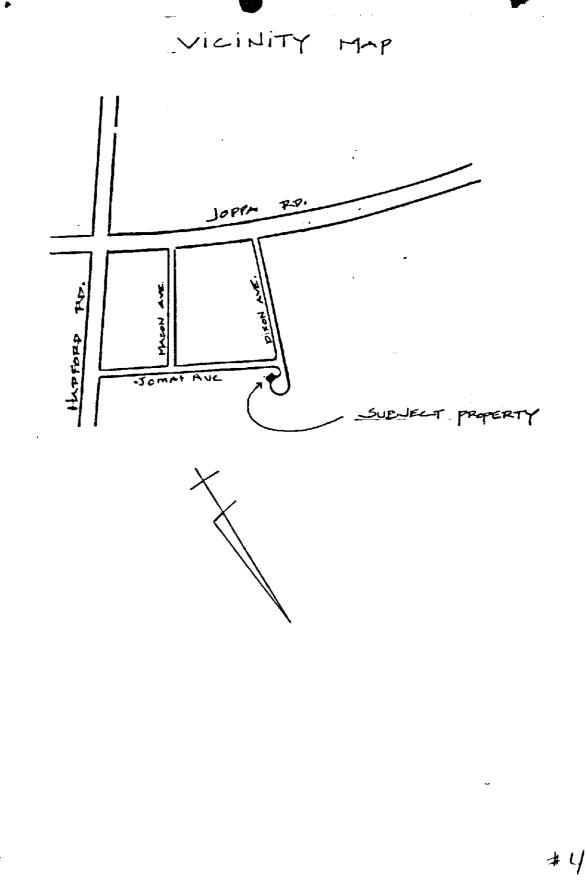

#404